



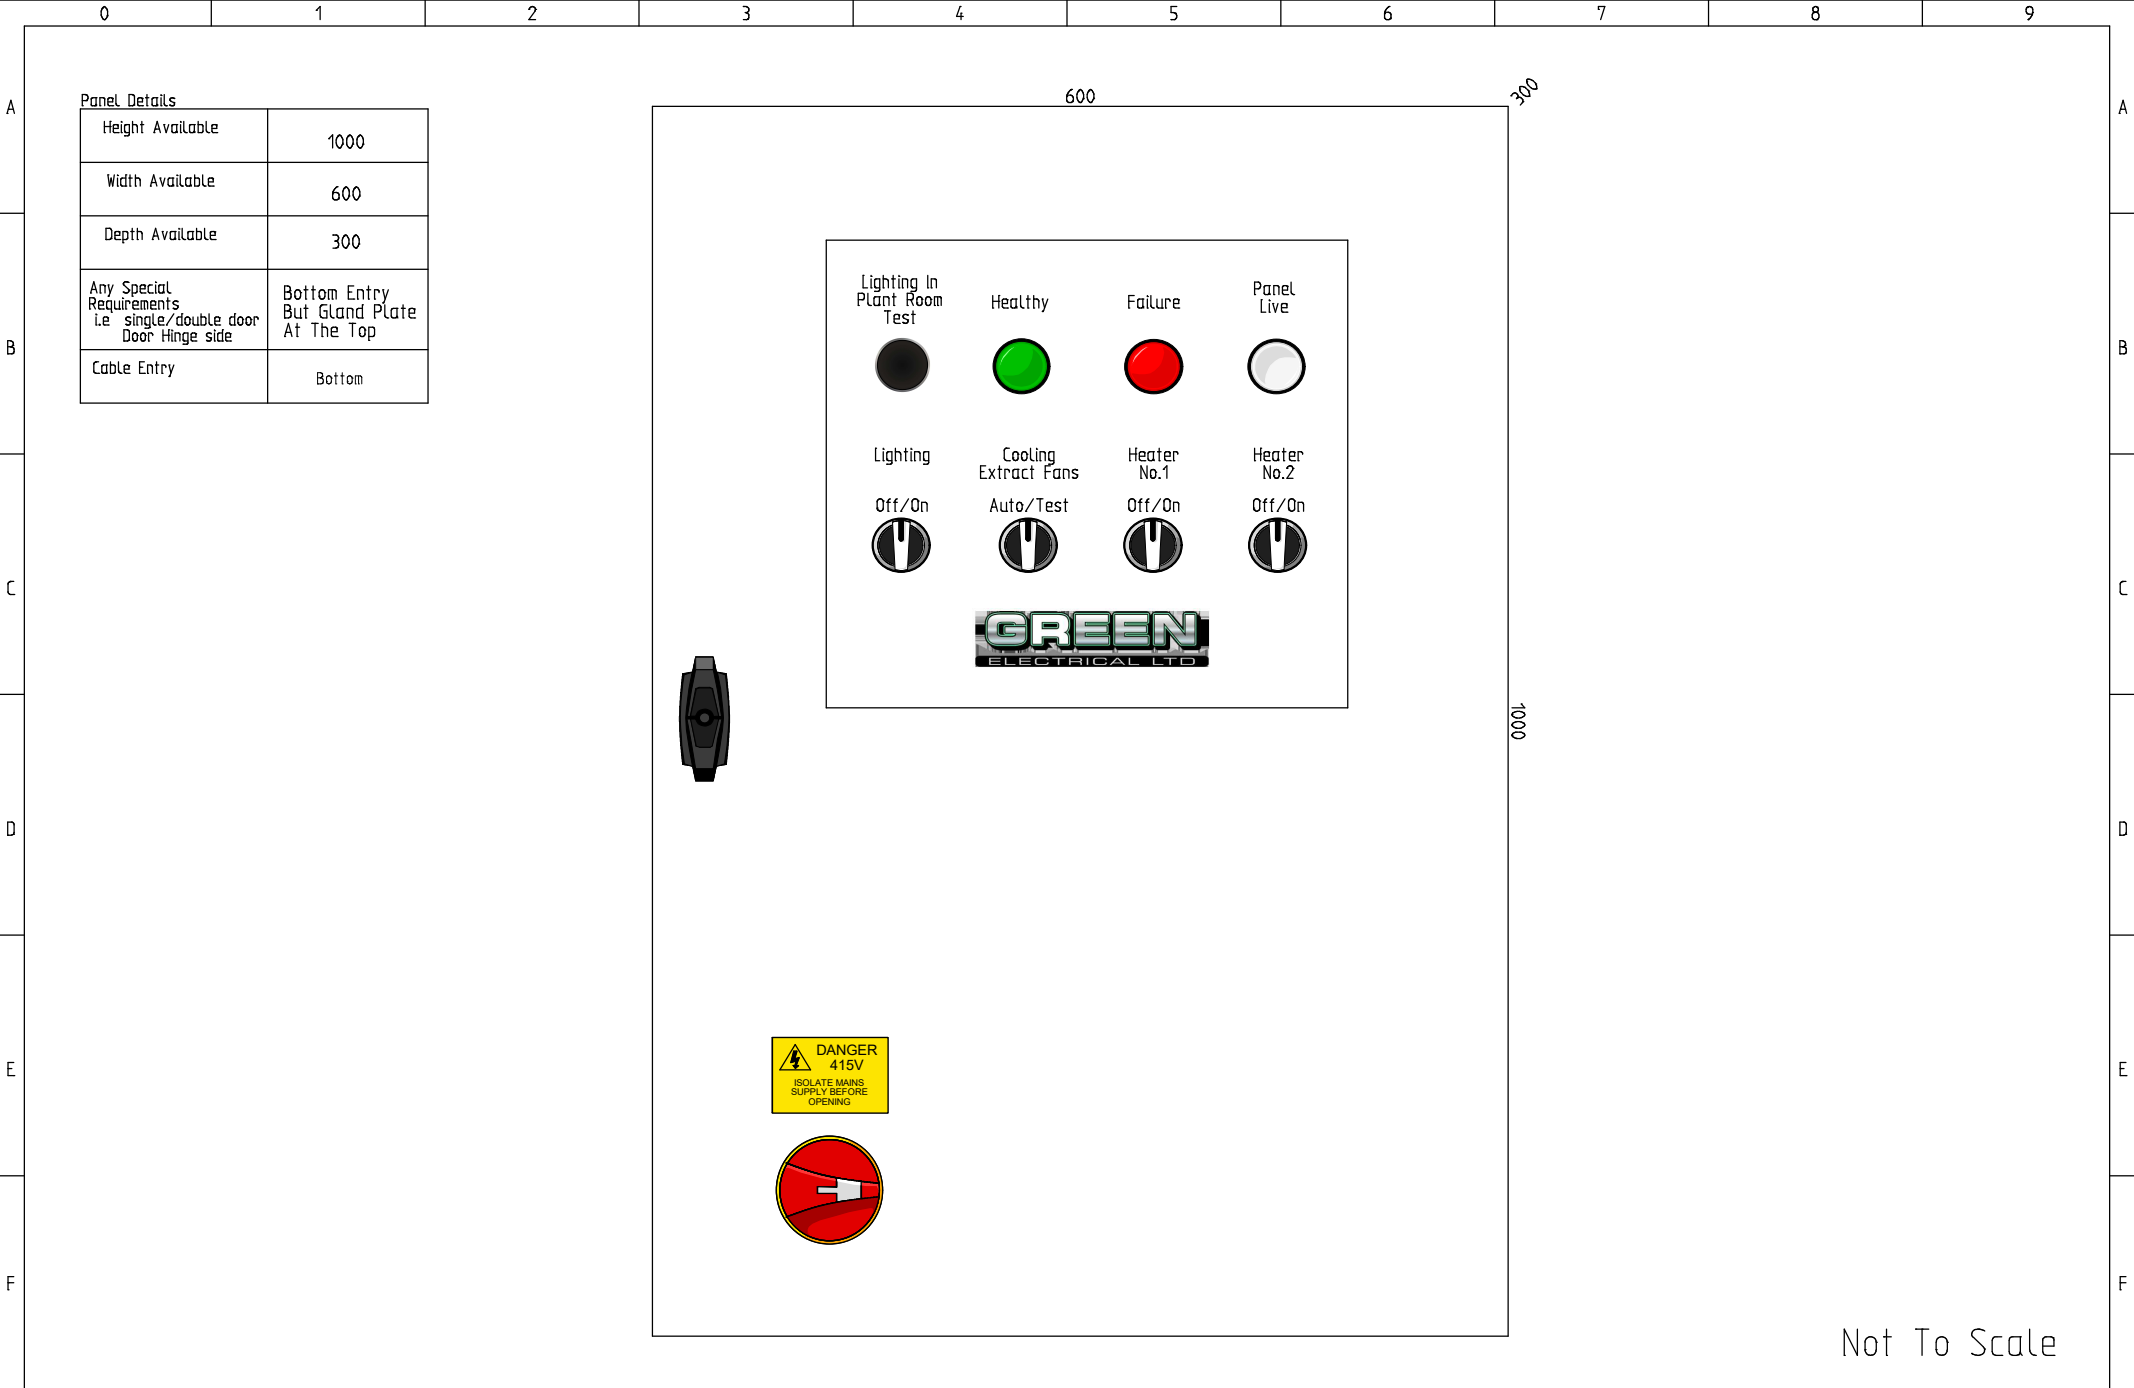

Project:	Green Electrical PCM Engineering 20-349	Serial No:	20-349	Drawn By:	W. Cumming	Rev.:	8	Sheet:	1
		Date:	26/06/2020	Function:	As Installed	Total sheets:	1	Next sheet:	

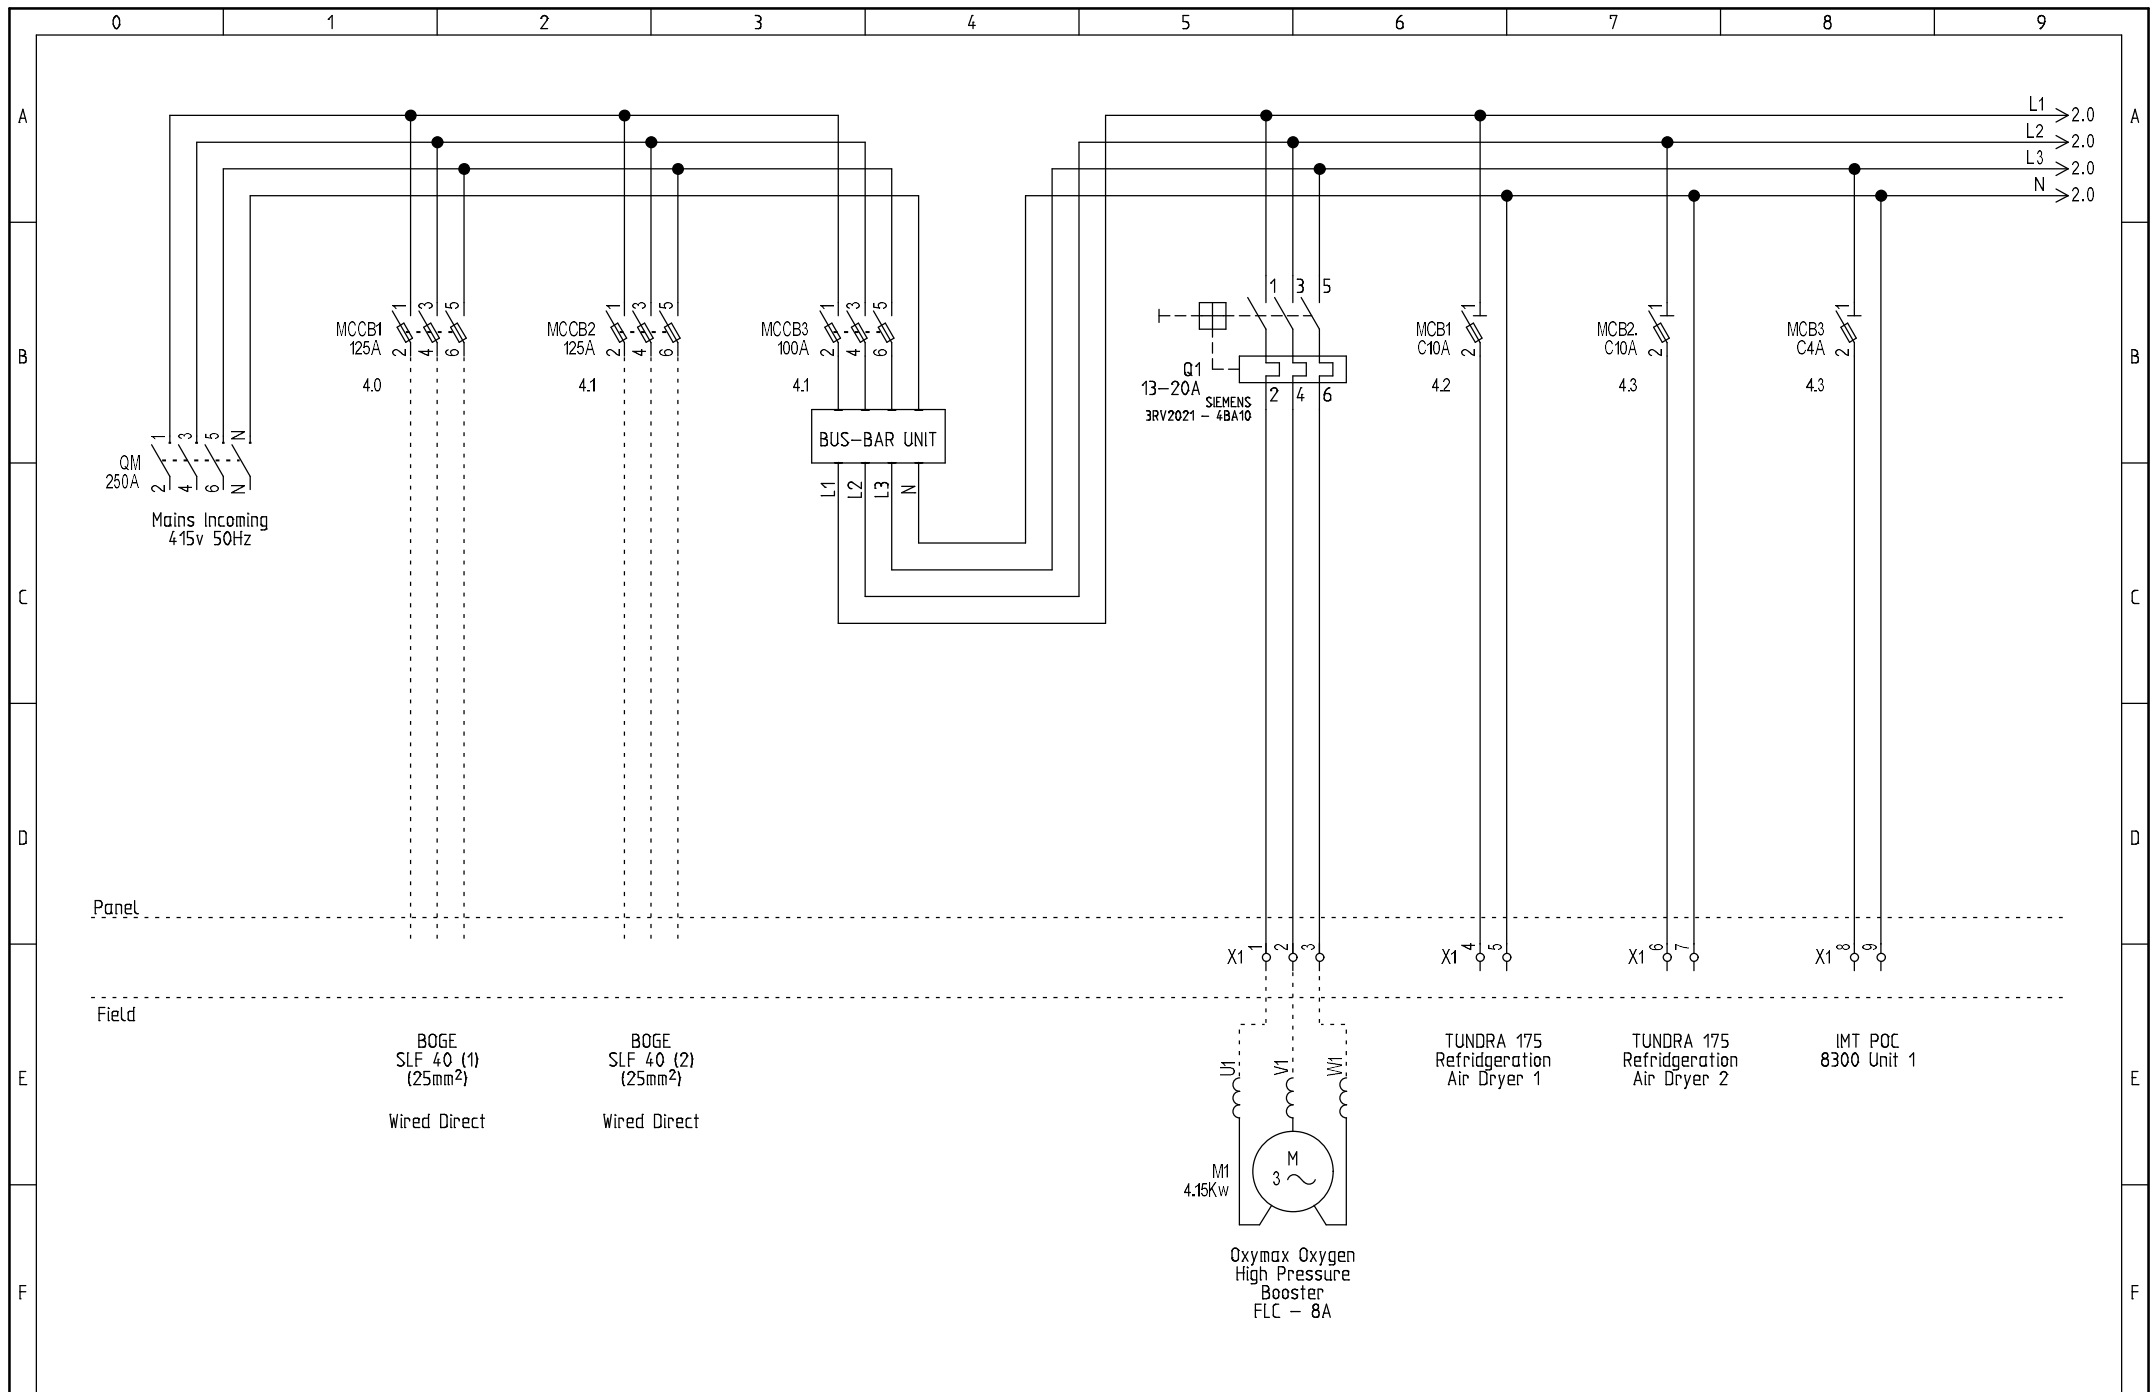

Project:

Green Electrical
PCM Engineering 20-349

Serial No:
20-349

Date:
26/06/2020

Drawn By:

W. Cumming

Function:


As Installed

Rev.:
8

Total sheets:
5

Sheet:
1

Next sheet:
2

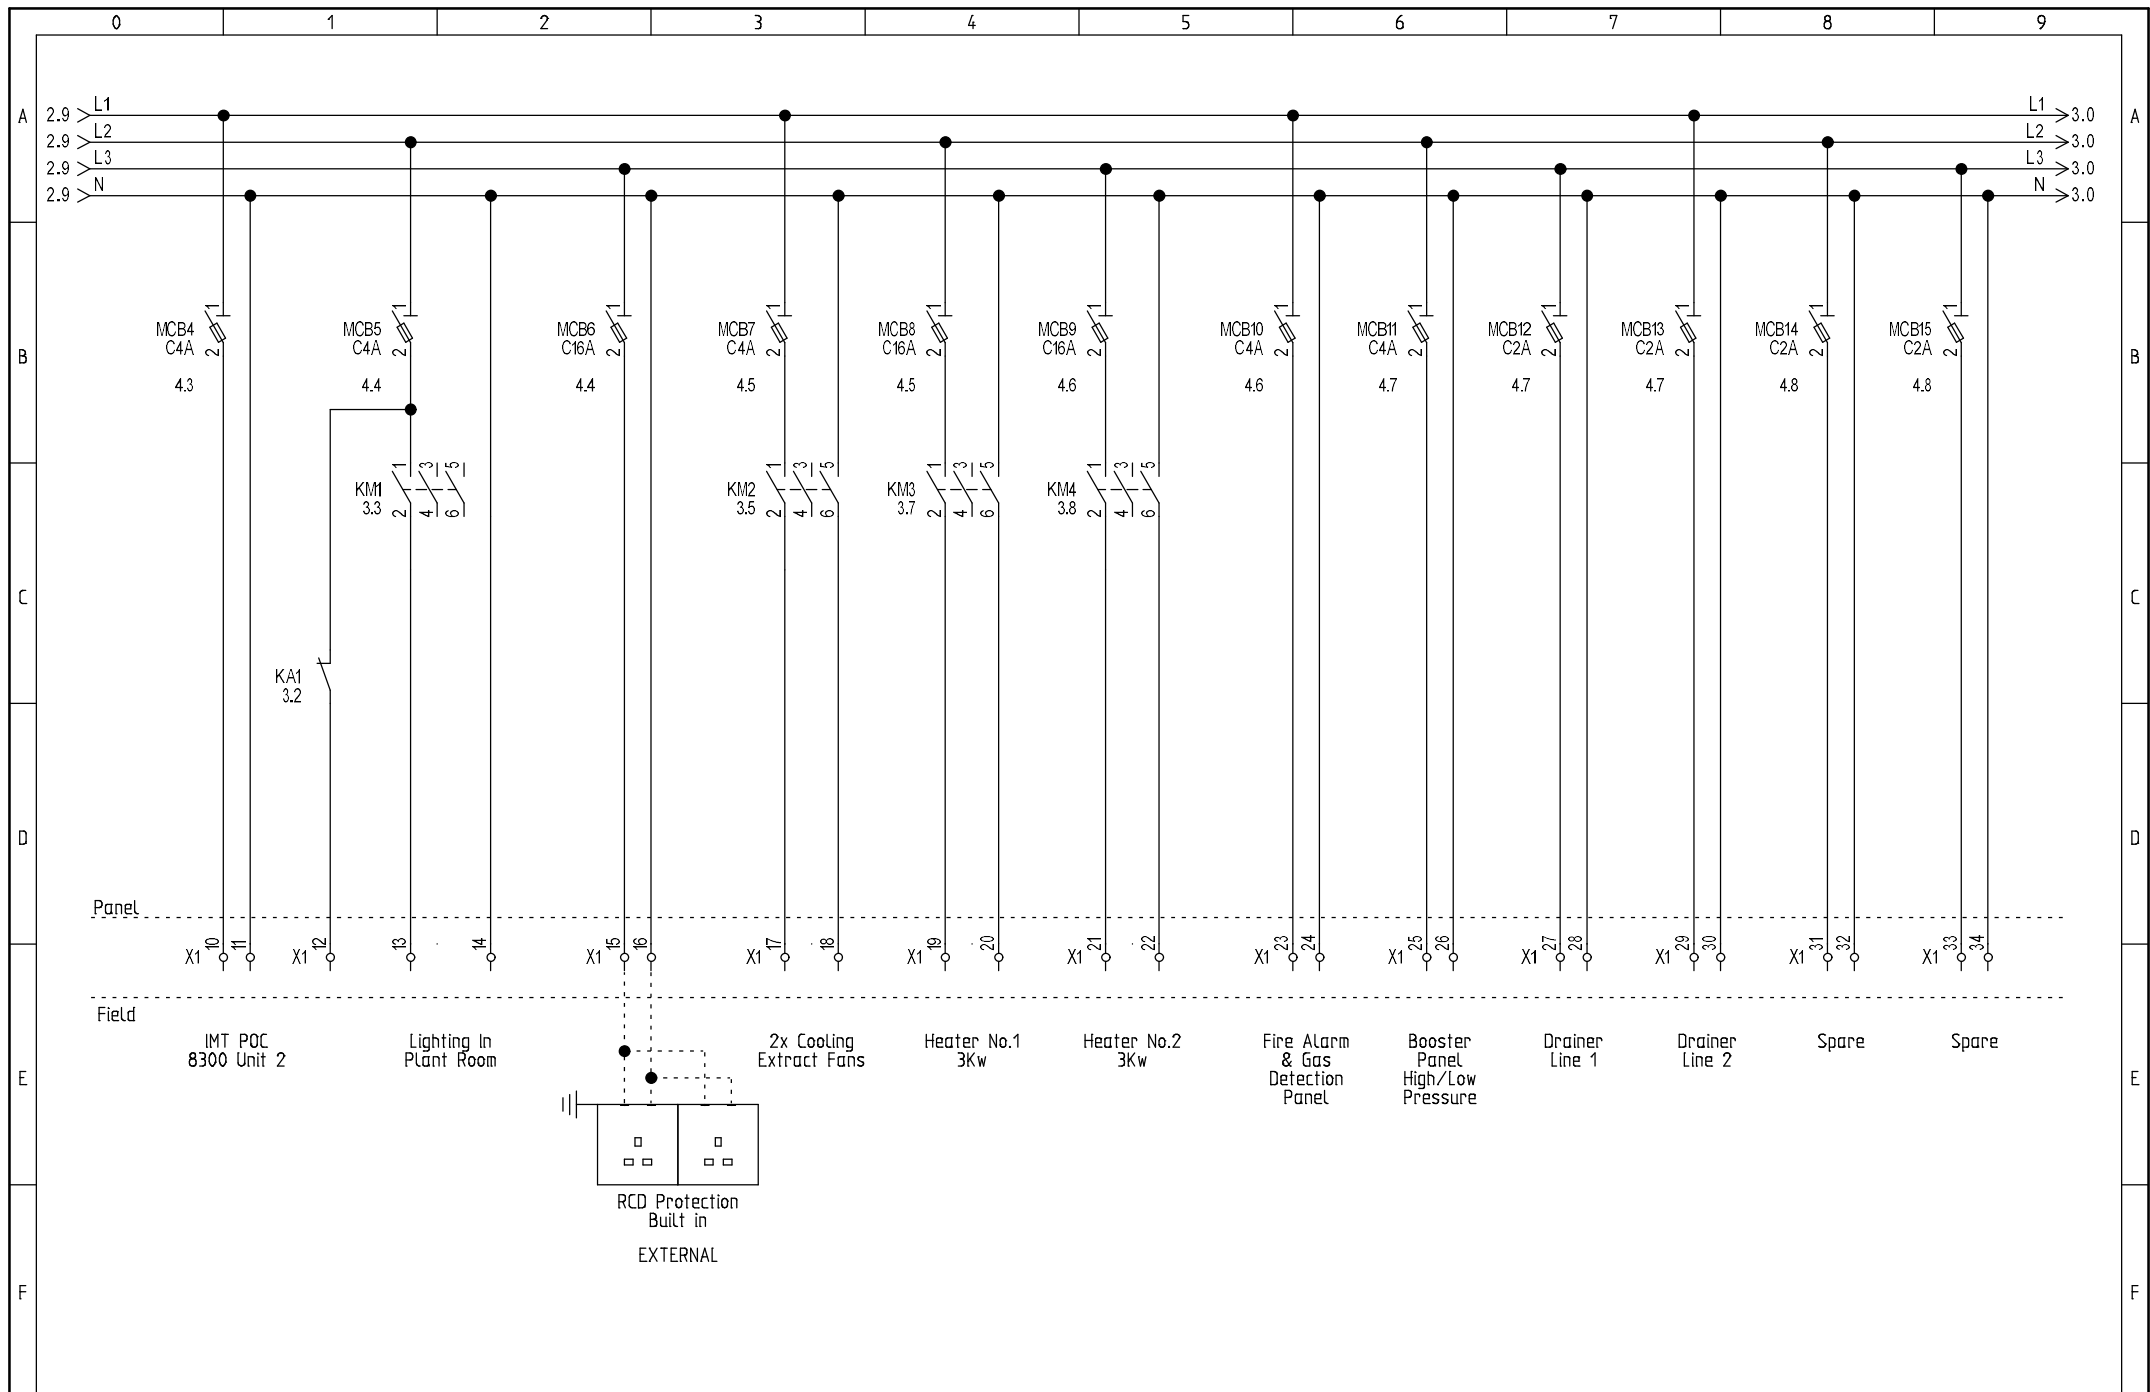

Project:

Green Electrical
PCM Engineering 20-349

Serial No:
20-349

Date:
26/06/2020

Drawn By:

W. Cumming

Function:

As Installed

Rev.:

8


Total sheets:
5

Sheet:

2

Next sheet:

3

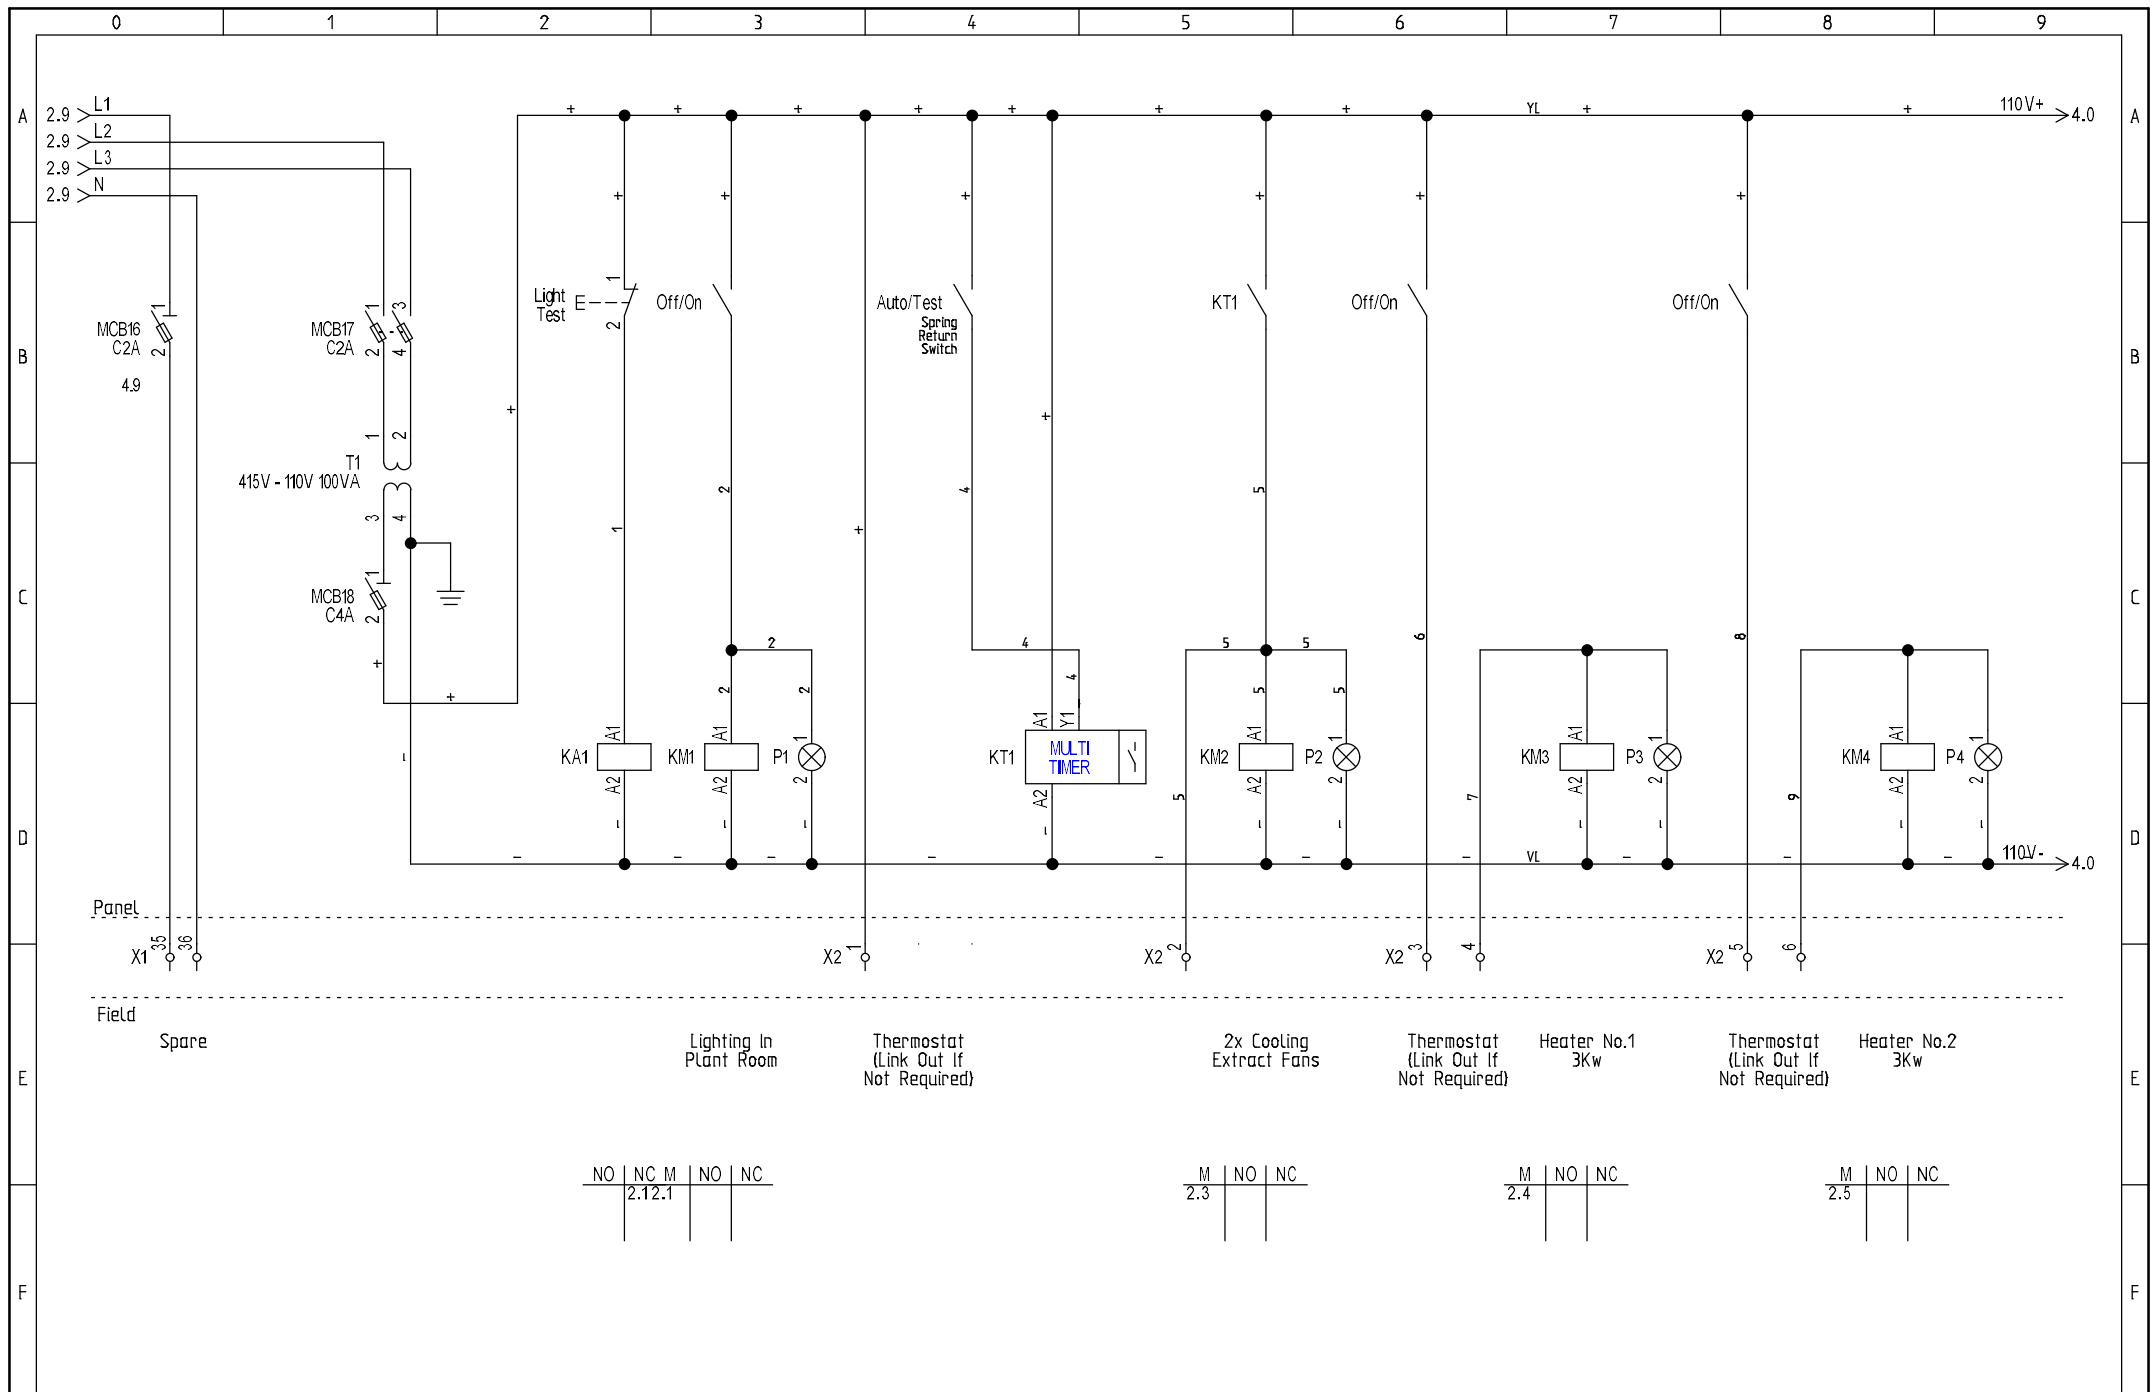

Project:

Green Electrical
PCM Engineering 20-349

Serial No:
20-349

Date:
26/06/2020

Drawn By:

W. Cumming

Function:


As Installed

Rev.:
8


Total sheets:
5

Sheet:
3

Next sheet:
4

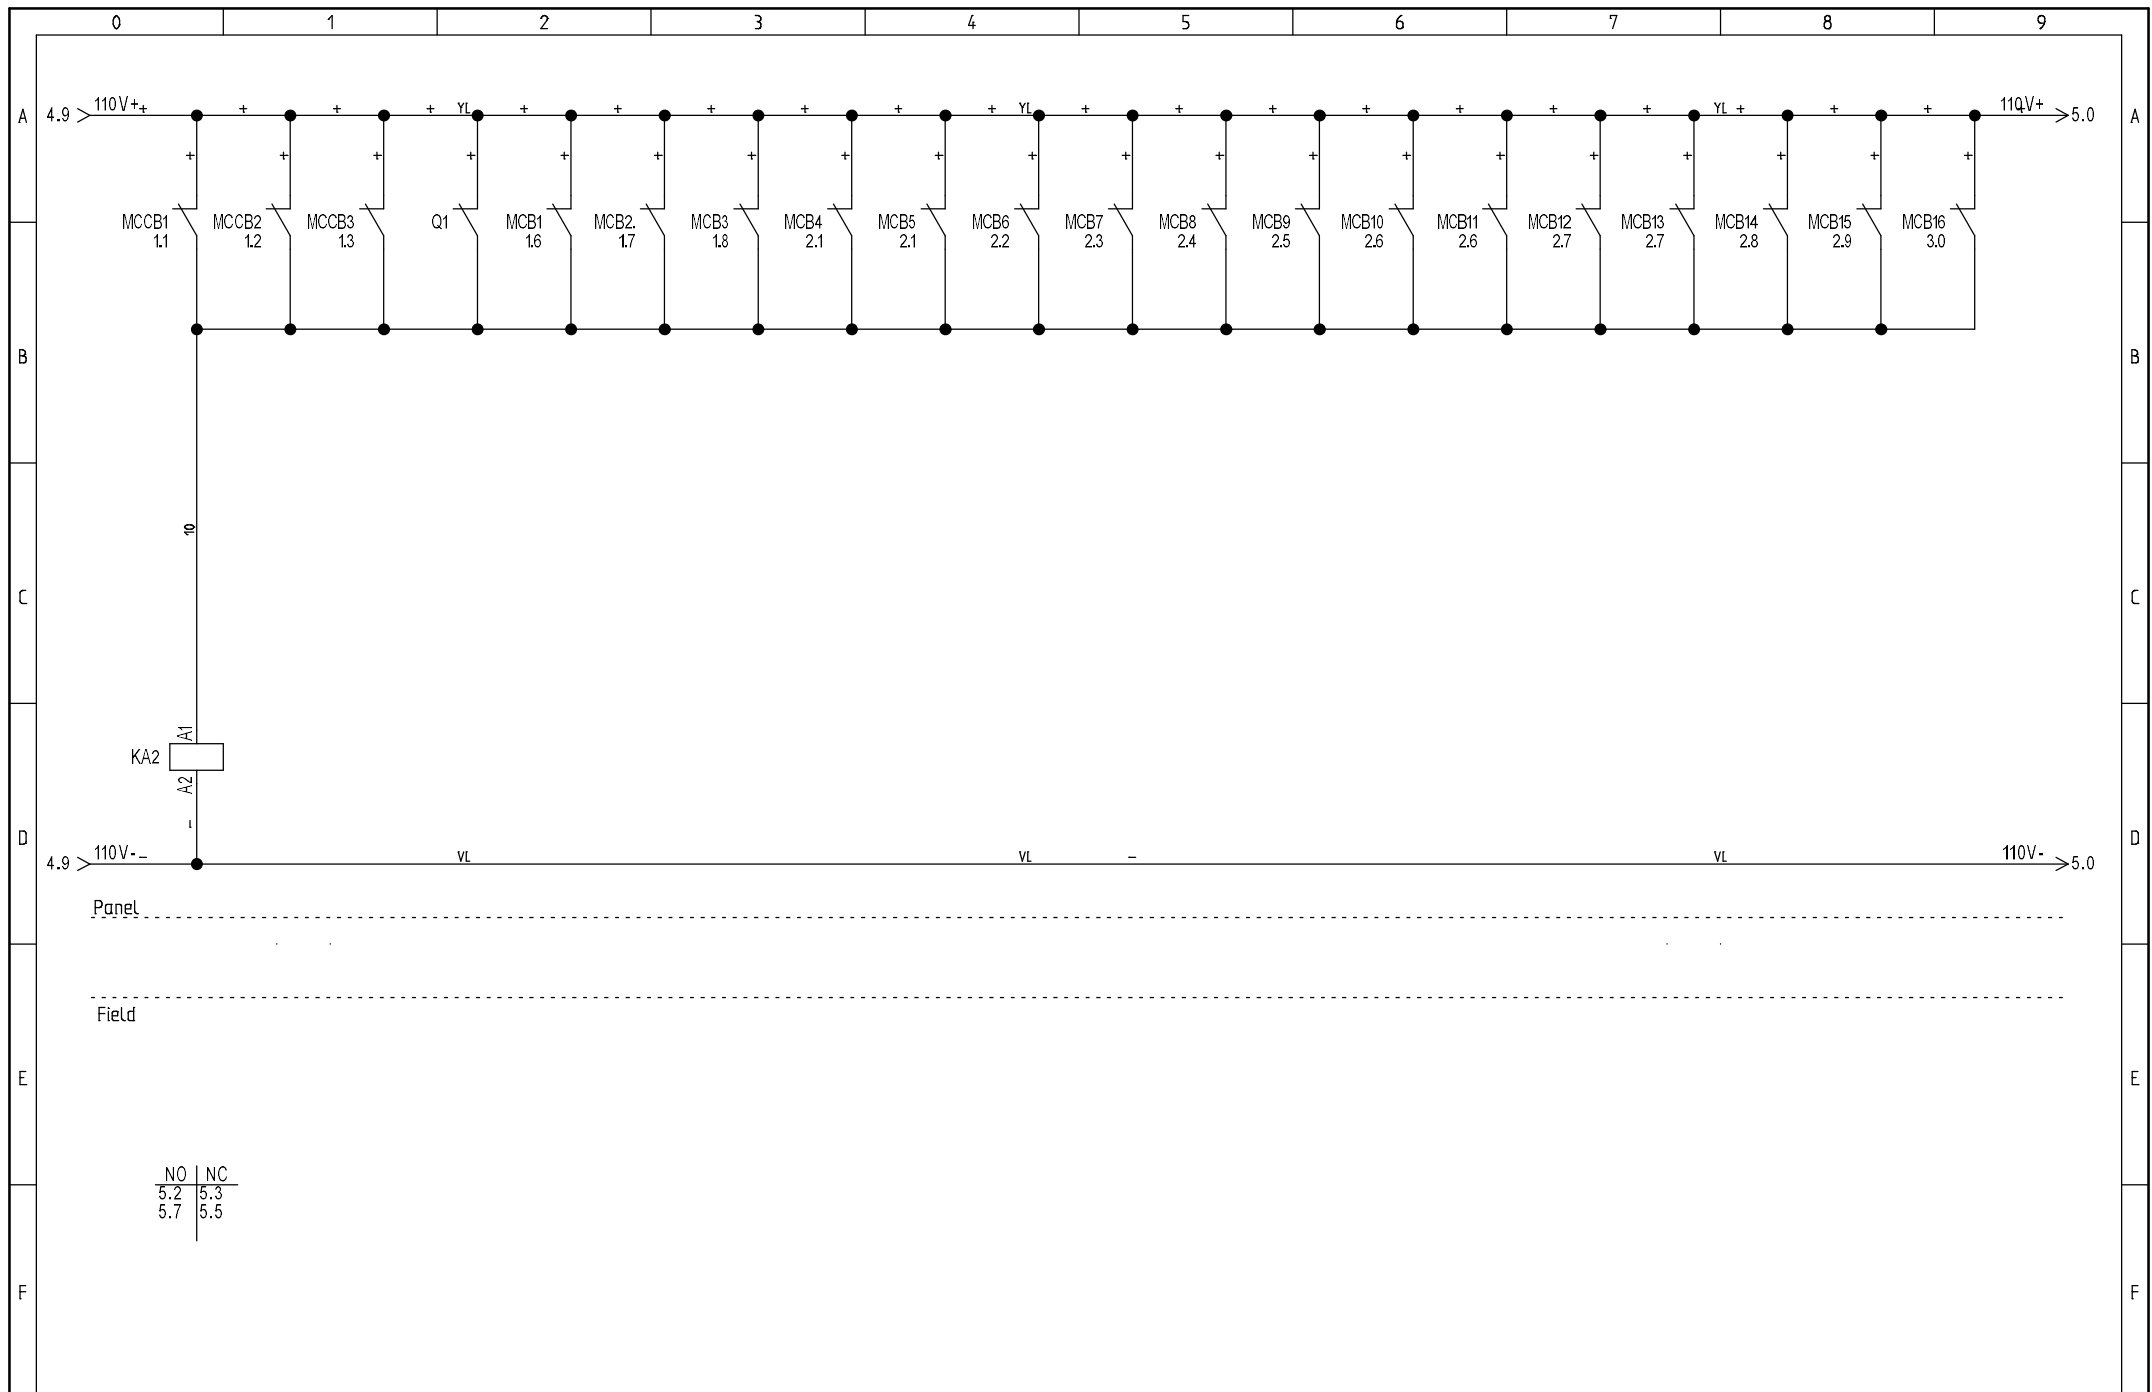

Project:	Green Electrical PCM Engineering 20-349	Serial No:	20-349	Drawn By:	W. Cumming	Rev.:	8	Sheet:	4
		Date:	26/06/2020	Function:	As Installed	Total sheets:	5	Next sheet:	5

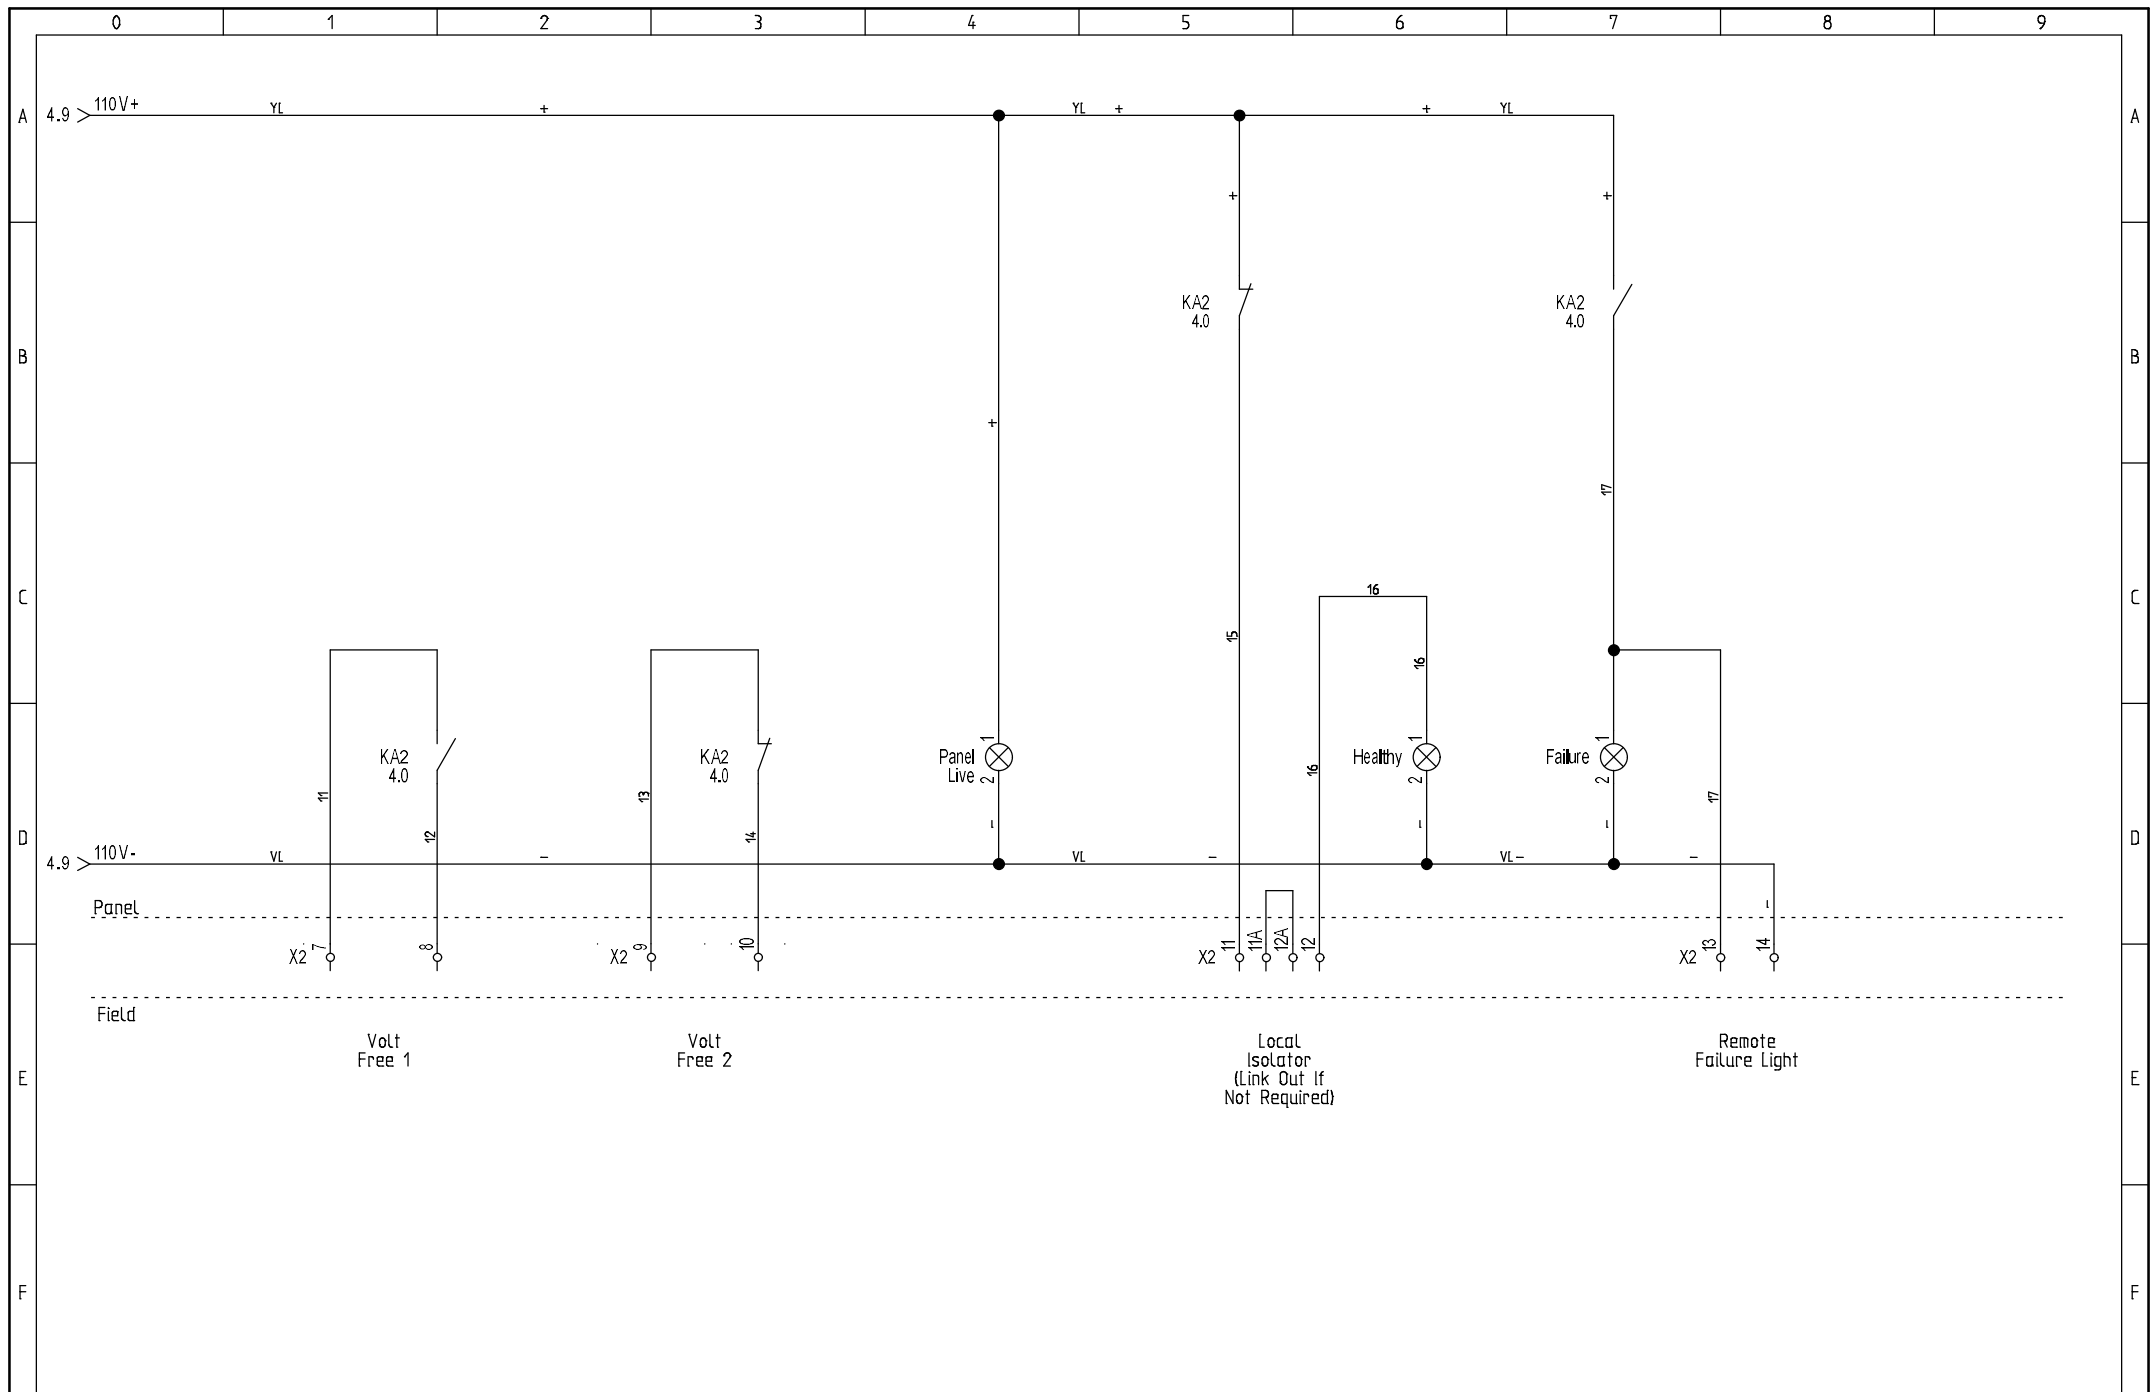

Project:

Green Electrical
PCM Engineering 20-349

Serial No:
20-349

Date:
26/06/2020

Drawn By:
W. Cumming

Function:
As Installed

Rev.:
8

Total sheets:
5

Sheet:
5

Next sheet: